

Service Installation Inspection Report

Subdivision: _____ Installation Date: _____
 Address: _____ Lot #: _____
 City: _____ Block: _____
 Permit #: _____ Residential: _____ Commercial: _____

Water and Sewer Service Sketch

Sewer Profile Sketch

Water service pressure test. Tested at (minimum 100) _____ lbs. for _____ minutes with zero loss.

General Notes:

- Approved inspection record is required prior to meter installation.
- File inspection record with District within three days of installation.
- The District reserves the right to reject any installation report due to lack of information.
- Sketch Criteria: Show N/S/E/W, lot lines, piping lengths, piping material, depths, couplings, fittings, clean-outs, curb stop box or meter pit referenced from two locations, sidewalk with “W” and “S” etch location, foundation, ground level, piping slope.

Installer Certification: (By signing, you are certifying that the installation meets all Uniform Plumbing Code requirements as published in the latest addition.)

Company Name: _____ Installer: _____
 Address: _____ Installer Signature: _____
 City: _____ State: _____ Zip: _____ Phone #: _____

Builder Certification: (By signing, you are approving the water and sewer services as installed)



Company Name: _____ Superintendent: _____
 Address: _____ Superintendent Signature: _____
 City: _____ State: _____ Zip: _____ Phone #: _____



Service Installation Inspection Report

Subdivision: Example
 Address: _____
 City: _____
 Permit #: Drawing

Installation Date: _____
 Lot #: _____
 Block: _____
 Residential: _____ Commercial: _____

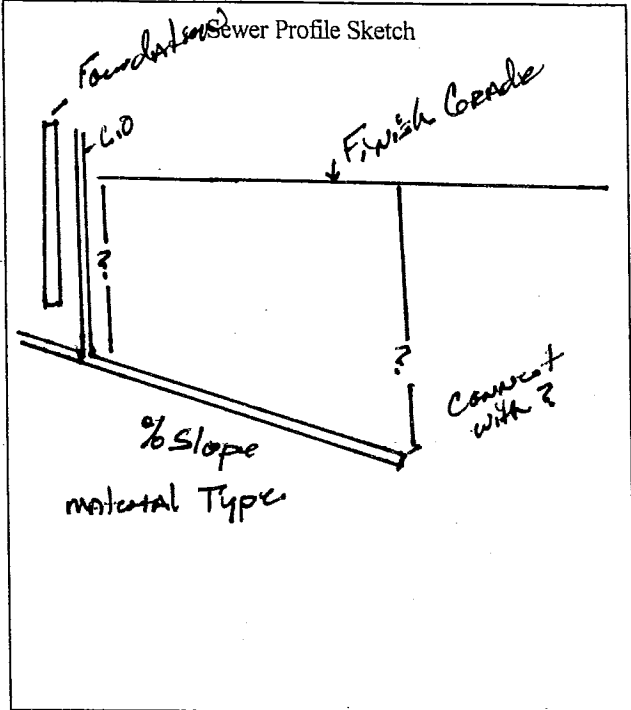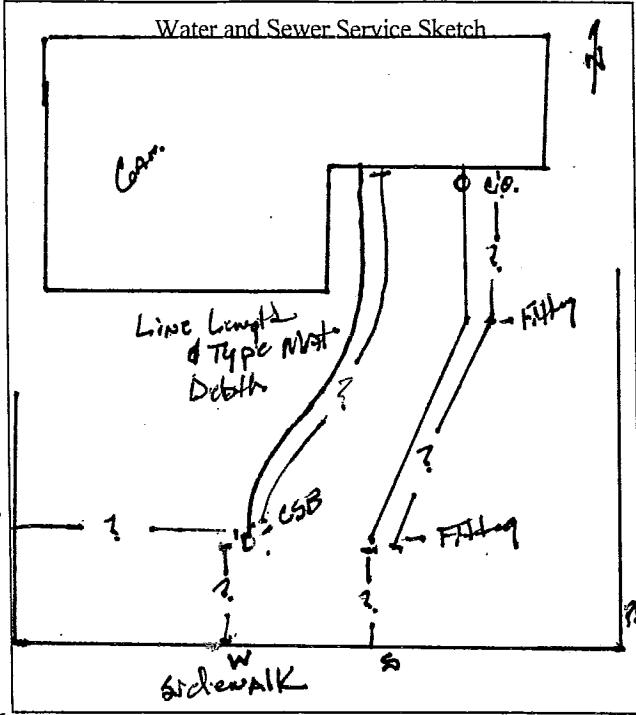

Info Needed

Water service pressure test. Tested at (minimum 100) _____ lbs. for _____ minutes with zero loss.

Info Needed

General Notes:

- Approved inspection record is required prior to meter installation.
- File inspection record with District within three days of installation.
- The District reserves the right to reject any installation report due to lack of information.
- Sketch Criteria: Show N/S/E/W, lot lines, piping lengths, piping material, depths, couplings, fittings, clean-outs, curb stop box or meter pit referenced from two locations, sidewalk with "W" and "S" etch location, foundation, ground level, piping slope.

Installer Certification: (By signing, you are certifying that the installation meets all Uniform Plumbing Code requirements as published in the latest addition.)

Company Name: _____
 Address: _____
 City: _____ State: _____ Zip: _____

Installer: _____
 Installer Signature: _____
 Phone #: _____

Builder Certification: (By signing, you are approving the water and sewer services as installed)

Company Name: _____
 Address: _____
 City: _____ State: _____ Zip: _____

Superintendent: _____
 Superintendent Signature: _____
 Phone #: _____